

Business Services Contracts Office 5735 47th Avenue ● Sacramento, CA 95824 (916) 643-2464 Janea Marking, Chief Business Officer Robert Aldama, Purchasing Manager II

ADDENDUM NO. 3

Date: May 13, 2024

Issued by: Sacramento City Unified School District

Project: Project #: 0521-470 West Campus HS Baseball/Softball Field Improvements

This addenda shall supersede the original Information, attachments, and specifications regarding Project No. 0521-470 where it adds to, deletes from, clarifies or otherwise modifies them. All other conditions and any previous addenda shall remain unchanged.

BIDDING REQUIREMENTS: None

TECHNICAL REQUIREMENTS: None


DRAWINGS: None

BIDDER QUESTIONS:

Q1: Addenda 1 answer A30 about the redwood header boards being shown on sheet L7.3. I don't see them nor do I see header boards on any other plan sheet. Addendum 2 did not answer the question that I can see. I cannot find the header board on sheet L7.3 anywhere. I suggest a markup on L7.3 showing the header board should be issued to clear this up, or at least liner foot given.

A1: L7.3 is attached with header board clouded. Approximately 45lf.

END OF ADDENDUM NO. 3 Acknowledgement of this Addendum will be required at time of bid.

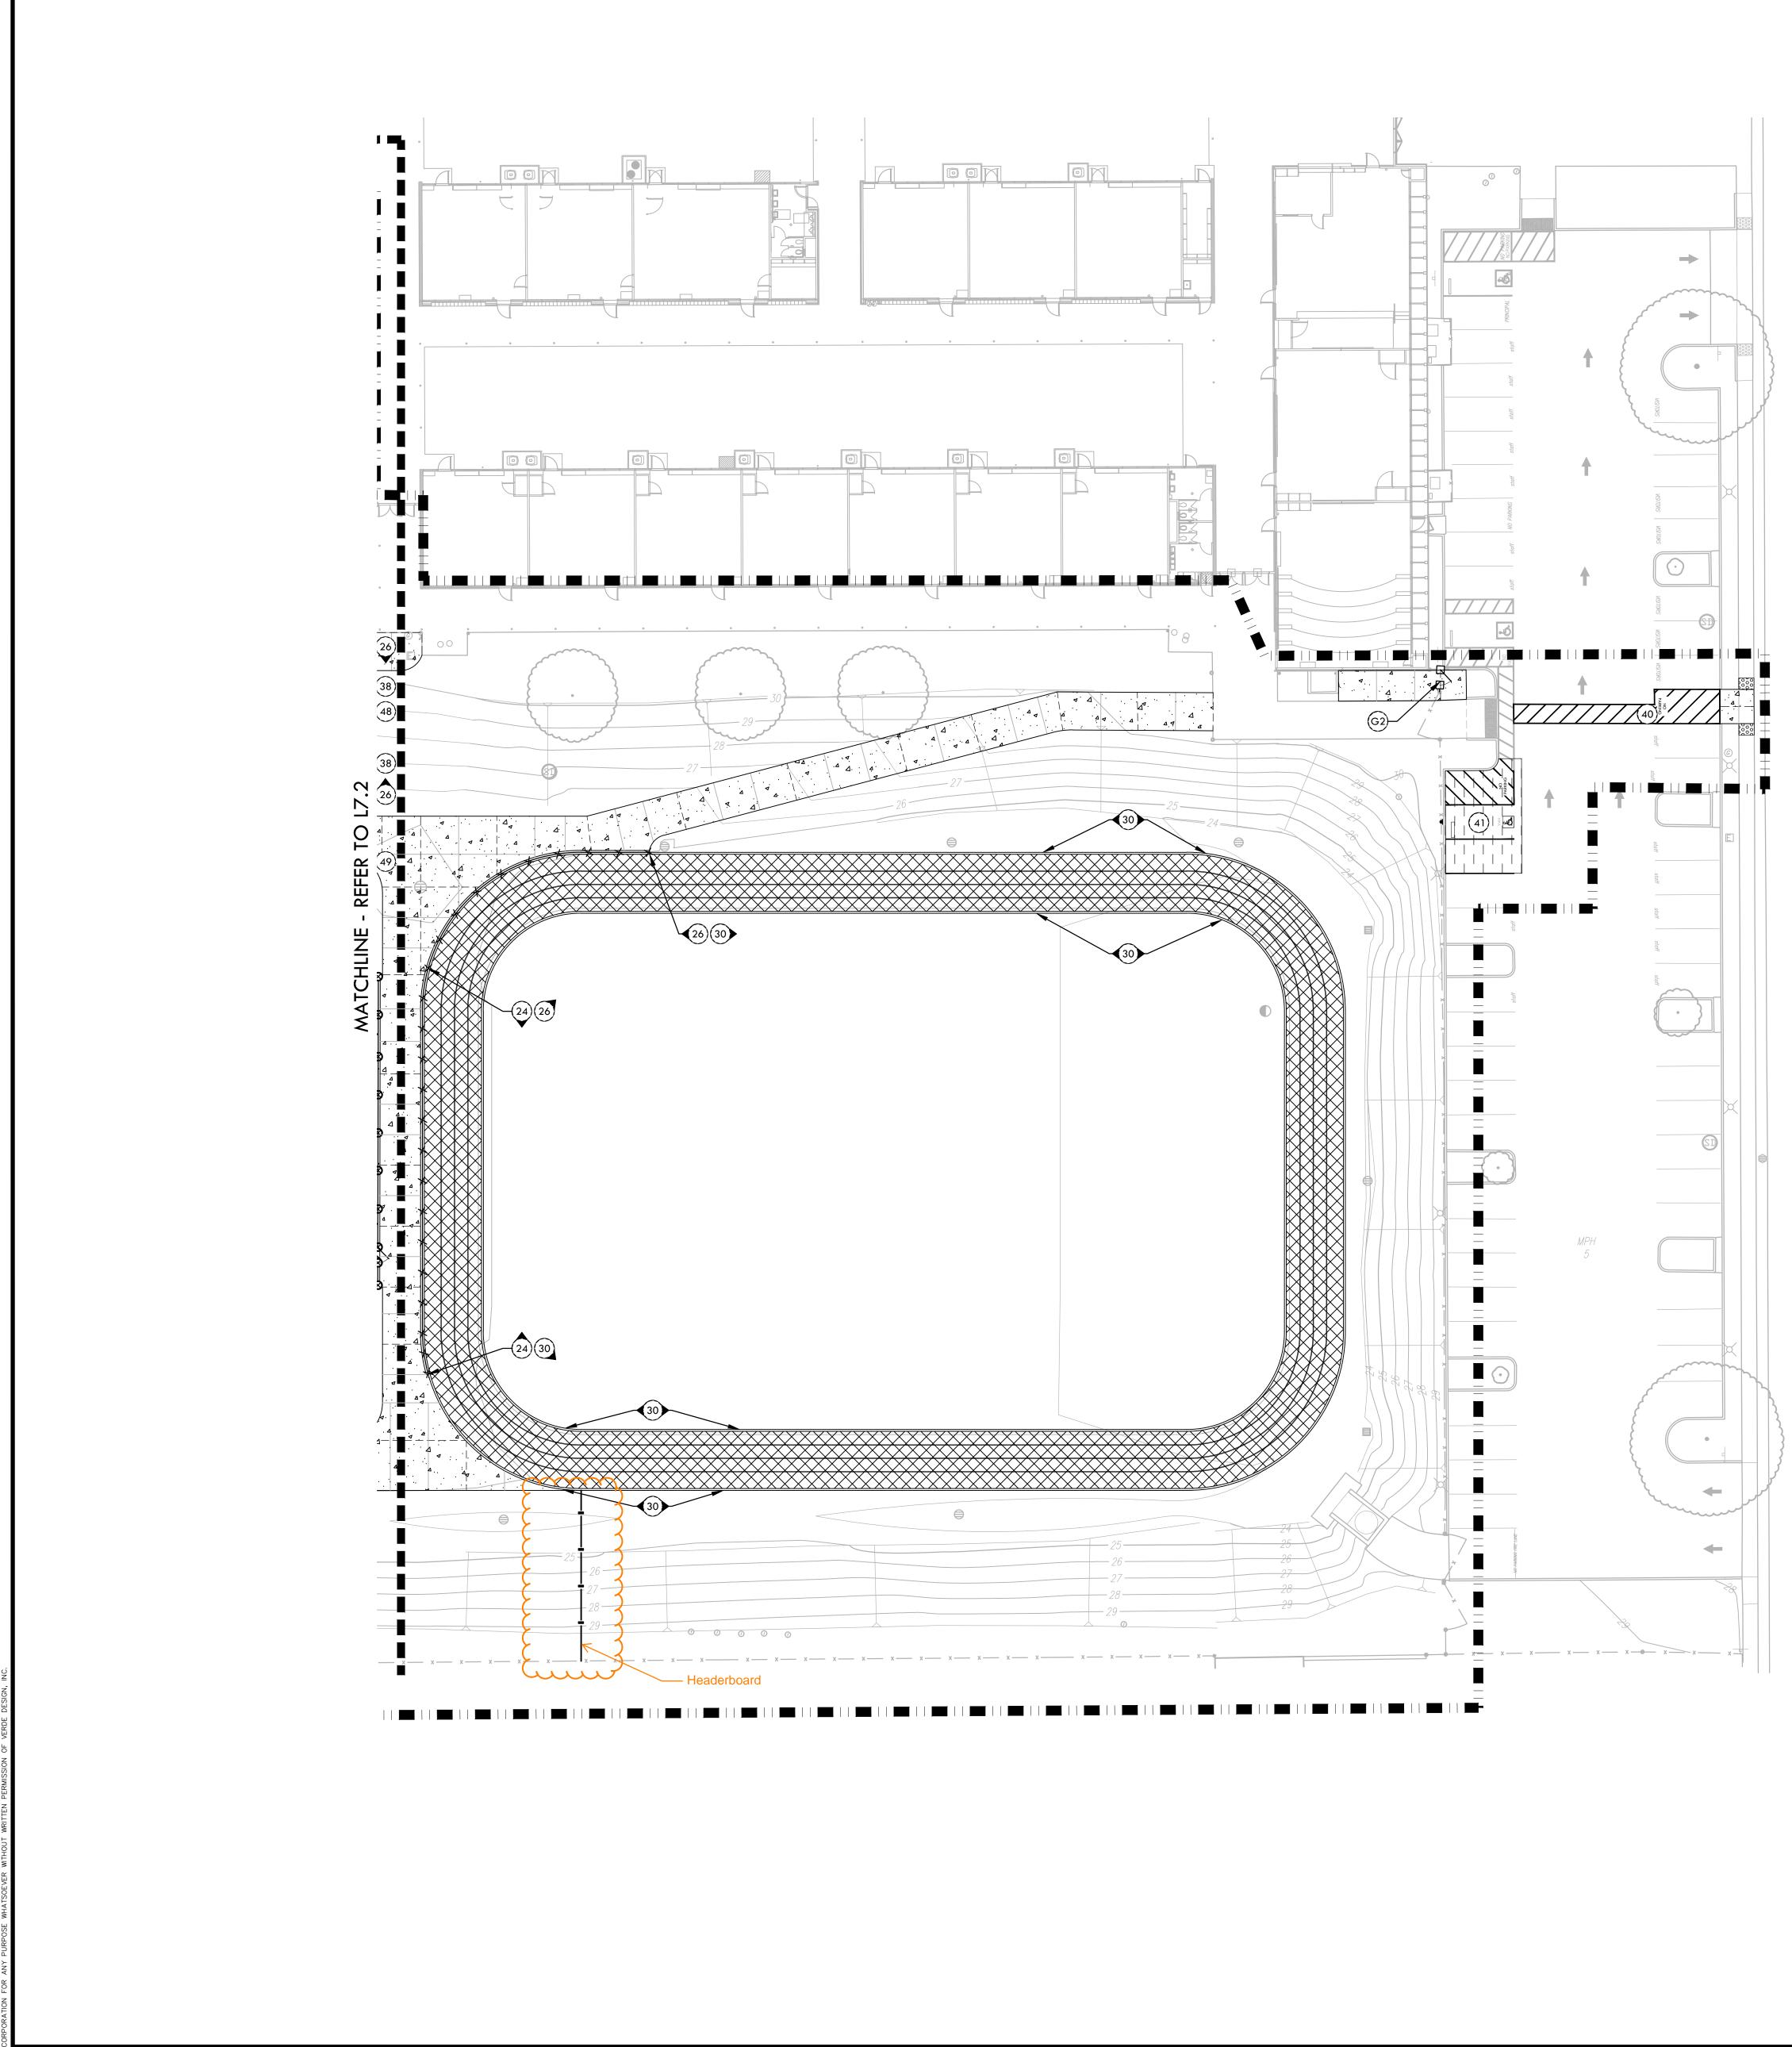

		MATERIAL LEGEND			MATERIAL NOTES	
F	SYM	DESCRIPTION BASEBALL SCOREBOARD, REFER TO NEVCO PLANS	DTL REF	LOCATIONS &	TOR SHALL COORDINATE ALL CONSTRUCTION ELEMENTS INCLUDING L REQUIRED SLEEVING PRIOR TO INSTALLATION. VERIFY CRITICAL DIMEN DINT LOCATIONS & CONSTRUCTION CONDITIONS PRIOR TO INITIATING	ISIC
F	(22)	PORTABLE BATTING PRACTICE HOOD, REFER TO SPECIFICATIONS		CONTRACTOR ARISE & REDIR	DN. TEMPORARY BENCHMARKS OR REFERENCE POINTS SHALL BE SET BY AS REQ. NOTIFY THE DISTRICT'S REP. IMMEDIATELY SHOULD DISCREPA ECT WORK TO AVOID DELAYS.	NC
-	23	6" CURB	l D2.1	SMOOTH & UI 3. ALL REINFORC	E OF ALL PROPOSED IMPROVEMENTS TO EXISTING SITE SHALL CONFOR NIFORM. ING & FORMS SHALL BE SECURED IN PLACE & ACCEPTED BY DISTRICT'S CING ANY CONCRETE.	
F	24	12" WIDE EDGEBAND	F D2.1	4. CONCRETE FIN ALL SPECIFIED	VISHES SHALL BE AS NOTED. CONTRACTOR SHALL PROVIDE 4'X4' SAMP FINISHES OF CONCRETE USING THE SAME MATERIALS THAT WILL BE US STRUCTION FOR EACH TYPE SPECIFIED. SAMPLES SHALL BE PREPARED W	ED
-	25	18" WIDE EDGEBAND WITH FENCE	G D2.1	RE-POURING (UNTIL ACCEPT	DVANCE OF SCHEDULED CONCRETE POUR TO ALLOW FOR REVIEW & I OF UNACCEPTABLE SAMPLES. UNACCEPTABLE SAMPLES SHALL BE RE-PR ED BY THE DISTRICT'S REP. ACCEPTED SAMPLES SHALL BE PROTECTED &	EPA
-	26	12" WIDE TALL CURB		5. ALL FENCES & SPECIFICATION	REFERENCE UNTIL FINAL ACCEPTANCE. GATES SHOWN ON PLAN ARE GRAPHIC REPRESENTATIONS; REFER TO NS FOR PRECISE LOCATION. LL NOT BE INSTALLED UNTIL ALL EDGES & SITE FURNISHING PADS ARE IN	
-	27	18" WIDE TALL CURB WITH FENCE	M D2.1	O. ASPRALI SRAI		131.
-	28	DRINKING FOUNTAIN- PEDESTAL	<u>К</u> D1.1	SYM	MATERIAL LEGEND	Tı
-	29	DRINKING FOUNTAIN - WALL MOUNTED	L D1.1		LIMIT OF WORK	+
-	30	6" WIDE EDGEBAND	E D2.1		SYNTHETIC TURF (NO INFILL)	+
-	31	RESTROOM BUILDING, REFER TO ROMTEC PLANS			INFIELD FINES	+
-	32	OUTFIELD DISTANCE BANNERS, REFER TO SPECIFICATIONS			WARNING TRACK FINES	+
-	33	FENCE CAP - YELLOW REFER TO SPECIFICATIONS			BASE BID- STABILIZED DECOMPOSED GRANITE ADDITIVE ALTERNATE 01- ALL WEATHER TRACK SURFACE	╡
	34	FENCE CAP - BLACK REFER TO SPECIFICATIONS		X X X X X X X X X X X X X X X X X X X	TRUNCATED DOMES - RECESSED	+
-	35	FIRE HYDRANT	D D1.2		CONCRETE PAVING PEDESTRIAN	(
-	36	COBBLE SPLASH BLOCK	G D1.2		ASPHALT PAVING - VEHICULAR	(
-	370 376	18" OUTFIELD WALL - ELEVATION (ALSO SEE STRUCTURAL) 12" OUTFIELD WALL - ELEVATION (ALSO SEE STRUCTURAL)	К D2.2		EXPANSION JOINT SCORE JOINT	(
_	38	STAIR HANDRAIL	C D2.2		CURB/ROADWAY SHALL BE PAINTED RED AND CLEARLY MARKED W WORDS IN WHITE PAINT "FIRE LANE – NO PARKING CVC 22500.1" ALSO TO SPECIFICATIONS AND DSA PL 07-03 FOR MORE INFORMA	' (R
	39	NEW ADA STALL	G D3.1		REDWOOD HEADER BOARD	
F	40	CROSSWALK	H D3.1	× × ×	42" TALL CHAIN LINK FENCE	(
-	(41)	RESTRIPE ADA STALL	F D3.1		GUARD RAIL SYSTEM	(
	(42)	5 ROW BLEACHERS, REFER TO SPECIFICATIONS (NOT FOR DSA REVIEW PER IR A-22)			6' TALL CHAIN LINK FENCE (WITHOUT SLATS) 6' TALL CHAIN LINK FENCE (WITH SLATS)	(
F	43	ELECTRICAL EQUIPMENT, REFER TO ELECTRICAL PLANS		<u> </u>	8' TALL CHAIN LINK FENCE (WITHOUT SLATS)	(
-	44	SHOVEL CUT EDGE	C D5.1	0-0-0	10' TALL CHAIN LINK FENCE (WITH SLATS)	+
-	(45)	CONCRETE CURB WITH CURB CUTS	H D2.1	• • •	12' TALL CHAIN LINK FENCE	(
-	(46)	TALL CURB @ BIORETENTION	J D2.1	<u> </u>	14'/16' TALL CHAIN LINK FENCE (REFER TO DETAIL FOR FENCE TYPE & SLAT LOCATIONS)	╡
-	47	CONCRETE CURB, GUTTER @ SIDEWALK	<u>К</u> D2.1	• • •	30' TALL CHAIN LINK BACKSTOP	╡
-	48	STAIRS- SECTION	A D2.2	G	PROTECTIVE NETTING OVER CHAIN LINK FENCE	+
-	49	STAIRS - ELEVATION	B D2.2		BIORETENTION AREA	╡
-	50	SOFTBALL OUTFIELD SECTION	(1 D2.2	G 1	42" TALL x 4' WIDE CHAIN LINK SWING GATE - ACCESSIBLE	+
-	51	BASEBALL OUTFIELD SECTION	J D2.2	62	6' TALL x 4' WIDE SWING GATE WITH PANIC HARDWARE	+
F	52	AREAS WHERE NEW WORK OCCURS SHALL BE RE-STRIPED WITH SIMILAR PAINT TYPE, COLOR AND LAYOUT.		63	6' TALL x 4' WIDE DOUBLE SWING GATE WITH PANIC HARDWARE	(
	l			64	6' TALL x 12' WIDE DOUBLE SWING GATE (WITH OR WITHOUT SLATS)	(
				65	6' TALL x 24' WIDE DOUBLE SWING GATE	(
				60	8' TALL x 4' WIDE CHAIN LINK SWING GATE WITH NETTING	(
				67	8' TALL x 4' WIDE CHAIN LINK SWING GATE WITH TRANSOM - ACCESSIBLE	(
				68	8' TALL x 4' WIDE DOUBLE SWING GATE WITH PANIC HARDWARE	(
				1	SOFTBALL INFIELD	(
				2	BASEBALL INFIELD	+
				3	SOFTBALL BACKSTOP ELEVATION	╡
				4	BASEBALL BACKSTOP ELEVATION	+
				5	FOUL POLE AT SOFTBALL, REFER TO SPECIFICATIONS	+
				6	FOUL POLE AT BASEBALL, REFER TO SPECIFICATIONS	(
				7	SOFTBALL BULLPEN (1ST BASE) - PLAN	+
				8	SOFTBALL CHAIN LINK DUGOUT - PLAN	+
				9	4 ROW BLEACHERS (6 TOTAL), REFER TO SPECIFICATIONS (NOT FOR DSA REVIEW PER IR A-22)	+
				10	SOFTBALL HOME DUGOUT - 3RD BASE SIDE	+
				(1)	SOFTBALL BULLPEN (3RD BASE) - PLAN	+
				(12)	SOFTBALL BATTING CAGE - PLAN	+
				(13)	SOFTBALL SCOREBOARD, REFER TO NEVCO PLANS	+
				(14)	FLAGPOLE, REFER TO SPECIFICATIONS & STRUCTURAL DETAIL	+
				(15)	BASEBALL BULLPEN (1ST BASE) - PLAN	+
				(16)	BASEBALL CHAIN LINK DUGOUT - PLAN	+
				17	BASEBALL HOME DUGOUT - 3RD BASE SIDE	+
				(18)	BASEBALL BULLPEN (3RD BASE) - PLAN	+
0' 10' 2		0' 60'		(19)	BASEBALL BATTING CAGE - PLAN	+
				20	ELEVATED SCORER'S TABLE BOOTH, REFER TO SPECIFICATIONS	+
				\smile	MATERIAL AN	⊥ D

